

NOT FOR CONSTRUCTION

IT IS A VIOLATION OF LAW FOR ANY PERSON TO ALTER ANY DOCUMENT WHICH BEARS THE SEAL OF A PROFESSIONAL ENGINEER, UNLESS THEY ARE ACTING UNDER THE DIRECTION OF A LICENSED PROFESSIONAL ENGINEER.


1320 S STREET  
ANDOVER, MA 01810

PROJECT NUMBER:  
120-0345

REV	DATE	DRAWN	CHECKED	RELEASE LEVEL
7	11/19/24	C/JN	NP	UTILITY REDLINES
8	11/20/24	C/JN	NP	UTILITY REDLINES

SCALES STATED ON DRAWINGS ARE VALID ONLY WHEN PLOTTED ARCH D 24" X 36"



MODIFICATION COMPARISON PLAN

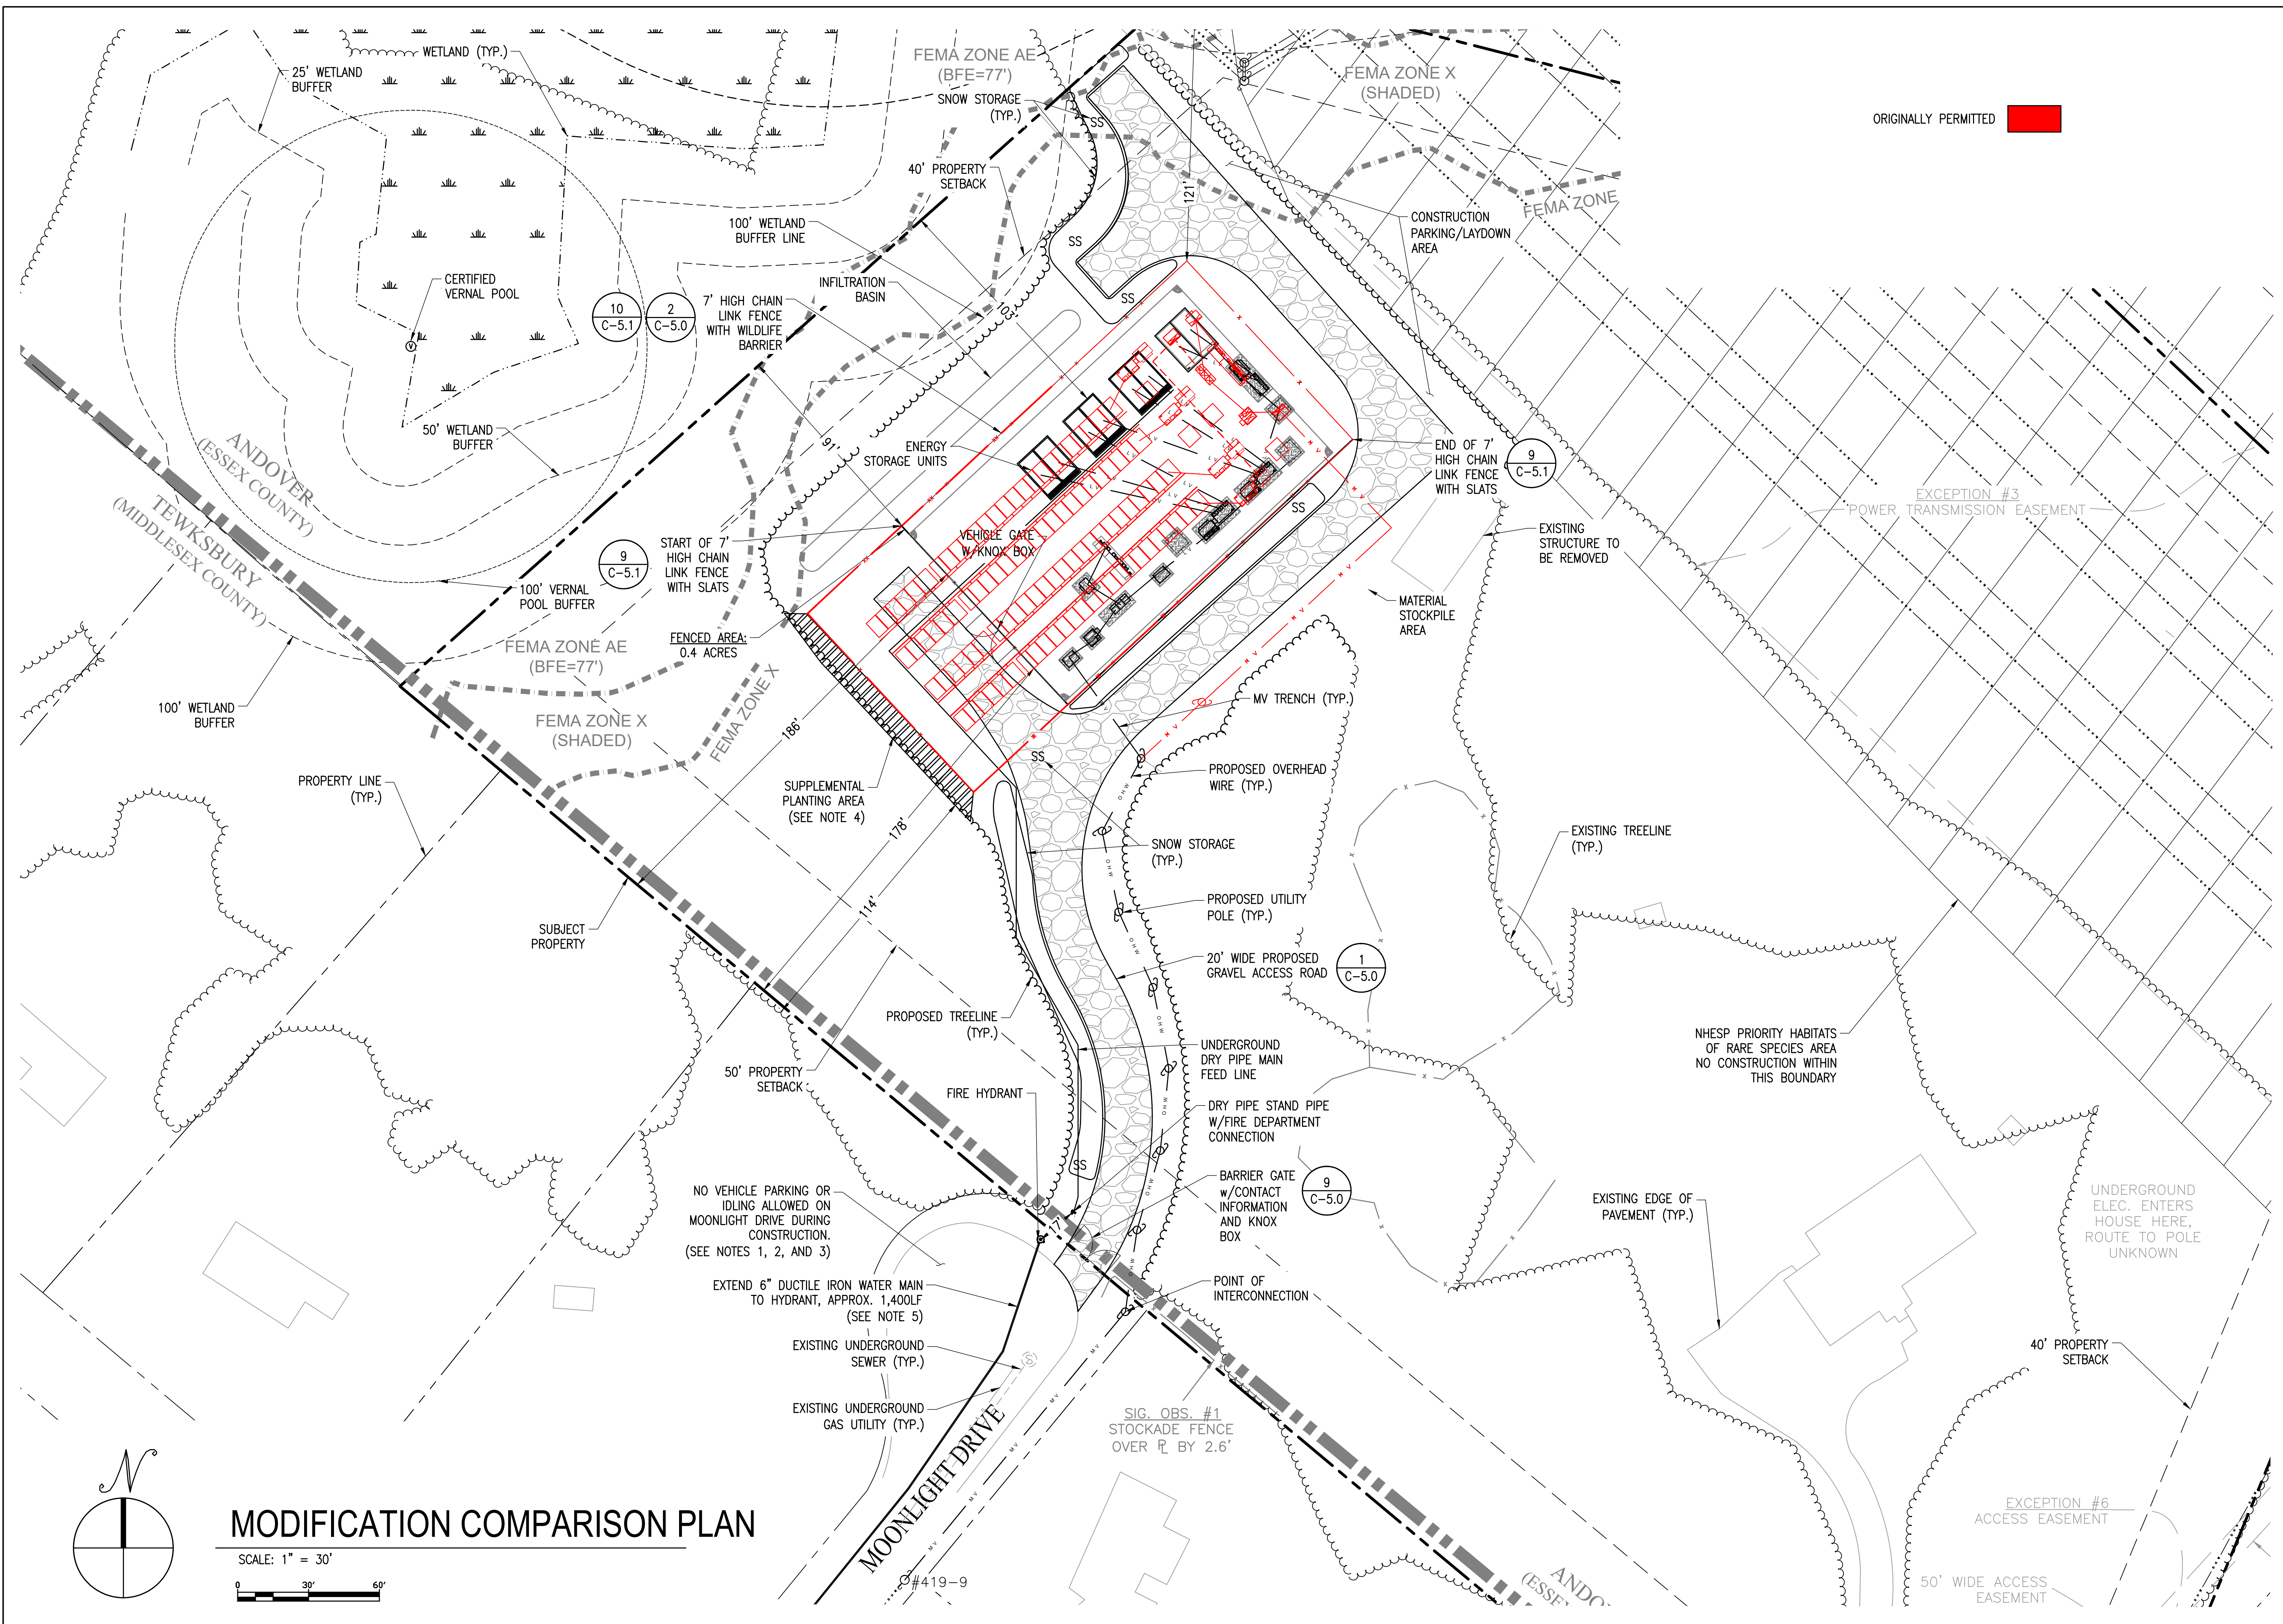

ORIGINALLY PERMITTED ■

# MODIFICATION COMPARISON PLAN

SCALE: 1" = 30'

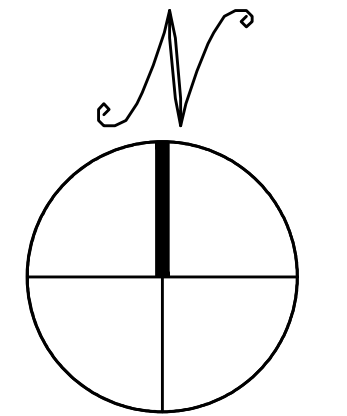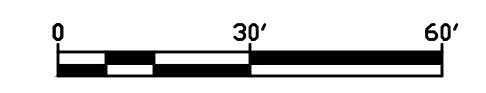

C:\Users\cortow\_r\newleafenergy\Box\Shareforce\Opportunities\1320 S Street - Andover\Design\Working Set\1320 S Street - Andover - SLP - 030322 - CS\Modification Comparison Plan.dwg